




2 no. rooflights to be installed over Office/Vestry - hidden from view by parapet wall. (Outline shown in red) See drawing 1922-043.

Proposed level path from existing public path to vestry door shown by dashed line. See separate drawing 1922/044

Proposed traditional solid timber doors with glazed fanlight above.

Rev A - Existing gates retained, restored and relocated inside arch behind swing of new doors.

See drawing 1922-048 - North Doors, for more detail

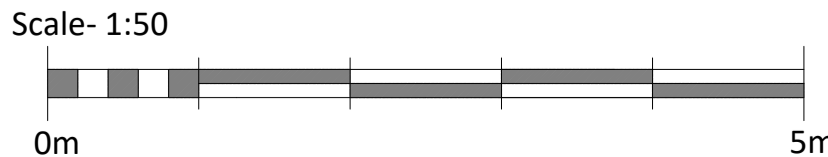

**CHEDBURN • CODD**  
CONSERVATION ARCHITECTS  
*Historic Building Consultants*  
Glove Factory Studios, 1 Brook Lane, Holt,  
Bradford-on-Avon, Wiltshire BA14 6RL  
T: 01225 859999 www.chedburn.com e: chedburn@chedburn.com

Project	St Lawrence Church Lechlade
Drawing	North Elevation As Proposed
Stage	RIBA Stage 3 - Planning
Drawing No.	1922/051/A
Scale	1:50 @ A1
Date	Jan 2023

A1 1st Sept 23 Notes on drawing revised to indicate north porch gates to be retained in new location within porch opening.